

OTTAWA COUNTY ENGINEERS OFFICE

REFERENCE NO. 36-8-13-A
 NW CORNER POST SEC. 36
 ALLEN TWP.
SHEET 1 OF 1.

ROUTE: T-70 CURTICE EAST AND WEST RD.
 @ T-214 OPFER-LENTZ RD.

TOWNSHIP: ALLEN


SECTION: 36

T 8 **NR** 13 **E.**

NORTHING:

EASTING:

DATUM:

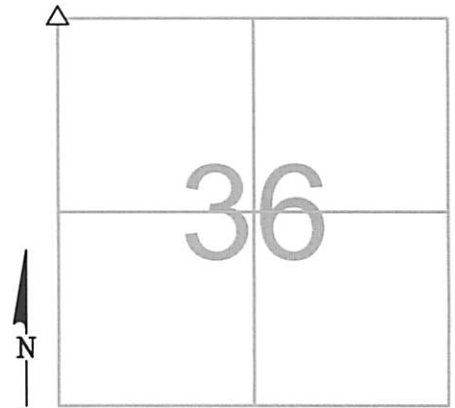


PERSONNEL:
 M. WITTMAN, P.S.
 J. ALLEN
 C. MILLER

DATE / WEATHER / TEMP:
 APRIL 26, 2013
 SUNNY - SW
 57° F

MONUMENT INFORMATION

MONUMENT TYPE: FD 5" x 9" HARDHEAD STONE
 ON SURFACE - BELOW: 1.70'
LEFT - CL PAV'T - RIGHT: 5.60' (T.R. 214)
 4.00' R (T.R. 70)

STONE IS 5" N/S AND 9" E/W
 USED DRILL HOLE FOUND IN STONE

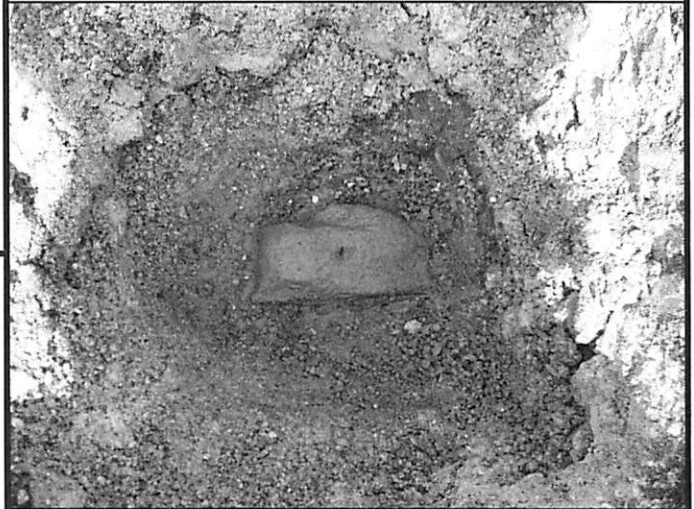

MISC. INFORMATION

FD.5/8" HEX HEAD BOLT 0.11' BELOW SURFACE,
 TIED W/ X-TIES AND DUG FOR STONE. HEX HEAD
 BOLT WAS DRIVEN INTO A 7/8" O.D. PIPE.

BOLT WAS 0.20' WEST AND 0.09' NORTH OF
 DRILL HOLE IN STONE.

MARCH 26, 2013

SET 1" SQUARE IRON PIN
 IN MONUMENT BOX OVER
 STONE

