

# OTTAWA COUNTY ENGINEERS OFFICE

REFERENCE NO. 36-8-13-D  
WEST QUARTER POST SEC. 36  
ALLEN TWP.  
SHEET 1 OF 1.

ROUTE: T-214 OPFER-LENTZ RD.

TOWNSHIP: ALLEN

SECTION: 36

T 8 NR 13 E.


NORTHING:

EASTING:

DATUM:

PERSONNEL:  
M. WITTMAN, P.S.  
J. ALLEN  
C. MILLER

DATE / WEATHER / TEMP:  
APRIL 26, 2013  
SUNNY - SE  
50° F

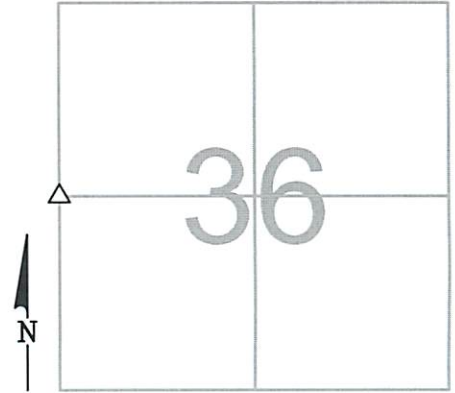

## MONUMENT INFORMATION

MONUMENT TYPE: FD. 12" x 8" LIMESTONE  
ON SURFACE - BELOW: 1.29'  
LEFT - CL PAV'T - RIGHT: 3.65'

STONE IS 12" N/S AND 8" E/W

USED DRILL HOLE FOUND IN STONE



## MISC. INFORMATION

FD. RR SPK 0.13' BELOW SURFACE, TIED W/ X-TIES  
AND DUG FOR STONE.

RR SPK WAS 0.07' WEST OF DRILL HOLE IN STONE

MARCH 26, 2013

SET 1" SQUARE IRON PIN  
IN MONUMENT BOX OVER  
STONE

