

# OTTAWA COUNTY ENGINEERS OFFICE

REFERENCE NO. 36-8-13-F  
EAST QUARTER POST SEC. 36  
ALLEN TWP.  
SHEET 1 OF 1.

ROUTE: C-213 NISSEN RD.

TOWNSHIP: ALLEN

SECTION: 36

T 8 NR 13 E.

PERSONNEL:  
M. WITTMAN, P.S.  
J. ALLEN


NORTHING:

EASTING:

DATUM:


DATE / WEATHER / TEMP:

JULY 28, 2014  
PTLY SUNNY, N-NW  
70° F

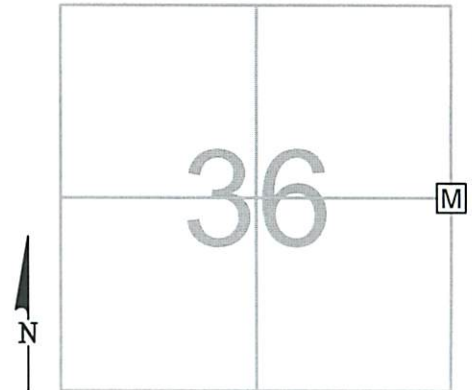

## MONUMENT INFORMATION

MONUMENT TYPE: SET 1" SQ. IRON PIN IN MON BOX  
ON SURFACE - BELOW:  
LEFT - CL PAV'T - RIGHT: 1.10'

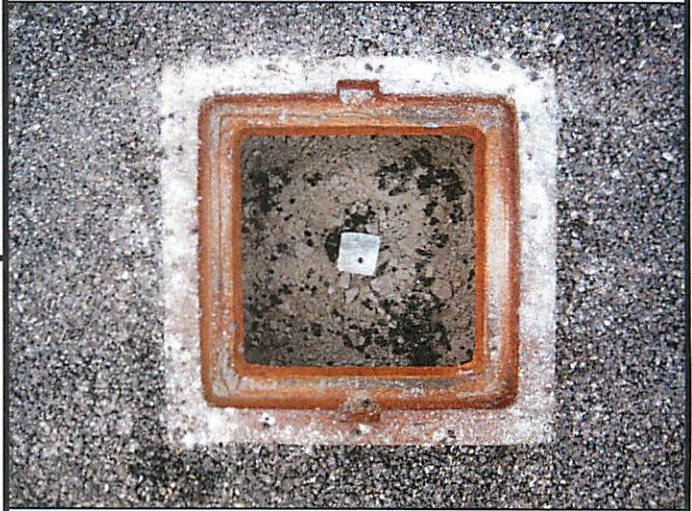

## MISC. INFORMATION

FD. RR SPK 0.25' BELOW SURFACE, TIED W/ GPS  
AND DUG FOR STONE (NO STONE OF RECORD).  
dUG DOWN 3.5 FEET TO CLAY, PRODDED ANOTHER  
2' AND DID NOT FIND A STONE. USED LOCATION OF  
RR SPK.

JULY 28, 2014

SET 1" SQUARE IRON PIN  
IN MONUMENT BOX

