## OTTAWA COUNTY ENGINEERS OFFICE

REFERENCE NO. 4-7-13-G

SW CORNER POST SEC. 4

ALLEN TWP.
SHEET 1 OF 1.

ROUTE: C-68 WALBRIDGE EAST RD.

@ T-53 REIMAN RD.

TOWNSHIP: ALLEN

**SECTION: 4** 

PERSONNEL:


M. WITTMAN, P.S. J. ALLEN T 7 NR 13 E.

NORTHING:

**EASTING:** 

DATE / WEATHER / TEMP:

JULY 15, 2013 SUNNY - HUMID 90° F DATUM:

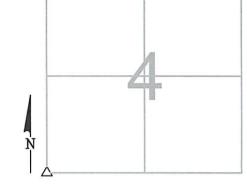

## MONUMENT INFORMATION

MONUMENT TYPE: 8" x 8" RD POINTED LIMESTONE

ON SURFACE - <u>BELOW</u>: 1.92' LEFT - CL PAV'T - RIGHT: 1.15'

**USED CENTER OF STONE** 

## MISC. INFORMATION

FD 1/2" Ø IRON PIN (CAPPED MARTIN) 0.11' BELOW SURFACE. TIED W/ X-TIES AND DUG FOR STONE. IRON PIN WAS 0.25' S AND 0.33' E OF CENTER OF STONE. (SEE PHOTO)



## JULY 15, 2013

SET 1" SQUARE IRON PIN IN MONUMENT BOX OVER STONE

WALBRIDGE EAST RD., C.R. #68

REIMAN RD. OCE BW ALL 23-50

