

OTTAWA COUNTY ENGINEERS OFFICE

REFERENCE NO. 4-7-13-H
SOUTH QUARTER POST SEC. 4
ALLEN TWP.
SHEET 1 OF 1.

ROUTE: C-68 WALBRIDGE EAST RD.

TOWNSHIP: ALLEN

SECTION: 4

T 7 NR 13 E.

PERSONNEL:
M. WITTMAN, P.S.
J. ALLEN
J. TIMMONS


NORTHING:

EASTING:

DATUM:

DATE / WEATHER / TEMP:

JULY 29, 2016
SUNNY - E
81° F

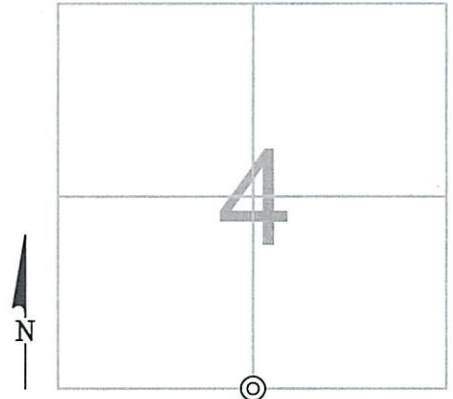

MONUMENT INFORMATION

MONUMENT TYPE: FD. 1" Ø IRON PIPE
ON SURFACE - BELOW: 0.75'
LEFT - CL PAV'T - RIGHT: 1.00'



MISC. INFORMATION

FD. RR SPIKE 0.35' BELOW SURFACE, TIED WITH
X-TIES AND DUG FOR IRON PIN AND/OR IRON PIPE
OF RECORD.

RR SPIKE WAS 0.07' E AND 0.04' S OF IRON PIPE.

SET MONUMENT BOX OVER IRON PIPE.

JULY 29, 2016

SET MONUMENT BOX OVER
FD. 1" Ø IRON PIPE.

