

# OTTAWA COUNTY ENGINEERS OFFICE

REFERENCE NO. 4-7-13-I  
SE CORNER POST SECTION 4  
ALLEN TWP.  
SHEET 1 OF 1.

ROUTE: C-51 GENOA CLAY CENTER RD.  
@ T-68 WALBRIDGE EAST RD.

TOWNSHIP: ALLEN

SECTION: 4

T 7 N R 13 E.

PERSONNEL:  
M. WITTMAN, P.S.  
M. BROUGH  
R. LAJTI, JR.


NORTHING:

EASTING:

DATUM:

DATE / WEATHER / TEMP:

JUNE 26, 2003  
CLDY  
70° F

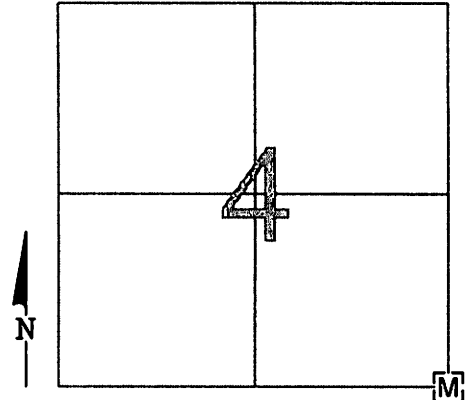

## MONUMENT INFORMATION

MONUMENT TYPE: FD 1" SQ. IRON PIN IN MON BOX  
ON SURFACE - BELOW:  
LEFT - CL PAV'T - RIGHT:

## MISC. INFORMATION

1" SQ. IRON PIN IN MONUMENT BOX SET 9-14-1971  
STATION 210+58.55 - 1962 C.R. #51 PLANS

PHOTO OF STONE NOT AVAILABLE

