

OTTAWA COUNTY ENGINEERS OFFICE

REFERENCE NO. 5-7-13-G
 SW CORNER POST SEC. 5
 ALLEN TWP.
SHEET 1 OF 1.

ROUTE: C-68 WALBRIDGE EAST RD.
 @ T- 54 BILLMAN RD.

TOWNSHIP: ALLEN

SECTION: 5


T 7 **NR** 13 **E.**

PERSONNEL:
 M. WITTMAN, P.S.
 J. ALLEN

NORTHING:

EASTING:

DATUM:

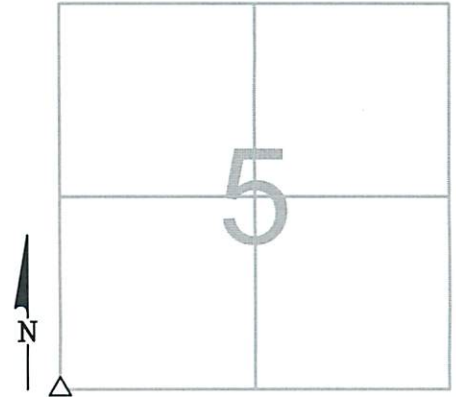

DATE / WEATHER / TEMP:
 JUNE 24, 2013
 SUNNY - S/SW
 84° F

MONUMENT INFORMATION

MONUMENT TYPE: 8" x 10" ROUND STONE W/ DH
 ON SURFACE - BELOW: 1.54'
 LEFT - CL PAV'T - RIGHT: 4.80'

USED DRILL HOLE



MISC. INFORMATION

FD RR SPK 0.17' BELOW SURFACE, TIED W/ X-TIES
 AND DUG FOR STONE. RR SPK WAS 0.05' EAST AND
 0.04' NORTH OF DH IN STONE.

JUNE 24, 2013

SET 1" SQUARE IRON PIN
 IN MONUMENT BOX OVER
 STONE

