

OTTAWA COUNTY ENGINEERS OFFICE

REFERENCE NO. 5-7-13-H
 SOUTH QUARTER POST SEC. 5
 ALLEN TWP.
 SHEET 1 OF 1.

ROUTE: C-68 WALBRIDGE EAST RD.

TOWNSHIP: ALLEN

SECTION: 5


T 7 NR 13 E.

PERSONNEL:
 M. WITTMAN, P.S.
 J. ALLEN

NORTHING:

EASTING:

DATUM:

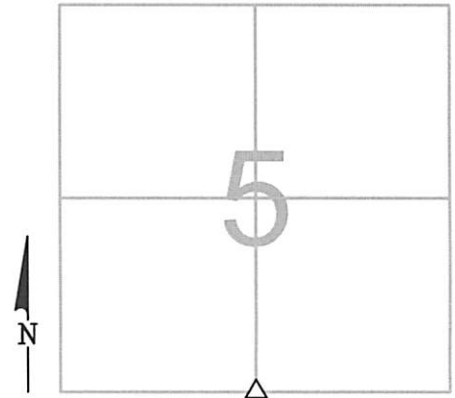

DATE / WEATHER / TEMP:

JUNE 27, 2013
 OVERCAST - HUMID
 76° F

MONUMENT INFORMATION

MONUMENT TYPE: FD. POINTED HARDHEAD STONE
 ON SURFACE - BELOW: 1.47'
 LEFT - CL PAV'T - RIGHT: 2.33'

4-1/2" x 4-1/4" x 4" ARROW SHAPED STONE
 STONE IS POINTING NORTH
 USED ARROW POINT OF STONE



MISC. INFORMATION

FD HARROWTOOTH 0.53' BELOW SURFACE, TIED W/
 X-TIES AND DUG FOR STONE. HARROW TOOTH
 MATCHED POINT OF STONE USED EAST AND WEST
 AND WAS 0.15' NORTH OF POINT.

JUNE 27, 2013
 SET 1" SQUARE IRON PIN
 IN MONUMENT BOX OVER
 STONE

