

# OTTAWA COUNTY ENGINEERS OFFICE

REFERENCE NO. 5-7-13-I  
SE CORNER POST SEC. 5  
ALLEN TWP.  
SHEET 1 OF 1.

PERSONNEL:  
M. WITTMAN, P.S.  
J. ALLEN

DATE / WEATHER / TEMP:  
JULY 15, 2013  
SUNNY - HUMID  
90° F

ROUTE: C-68 WALBRIDGE EAST RD.  
@ T-53 REIMAN RD.

TOWNSHIP: ALLEN


SECTION: 5

T 7 NR 13 E.

NORTHING:

EASTING:

DATUM:

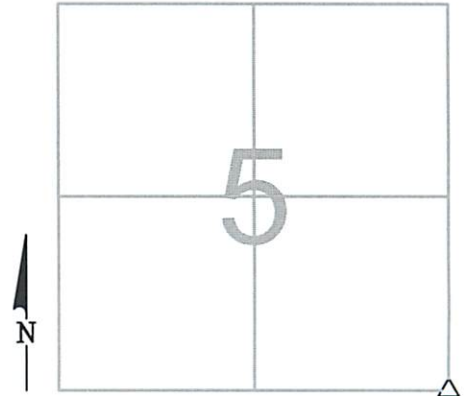

## MONUMENT INFORMATION

MONUMENT TYPE: 8" x 8" RD POINTED LIMESTONE  
ON SURFACE - BELOW: 1.92'  
LEFT - CL PAV'T - RIGHT: 1.15'

USED CENTER OF STONE



## MISC. INFORMATION

FD 1/2" Ø IRON PIN (CAPPED MARTIN) 0.11' BELOW  
SURFACE. TIED W/ X-TIES AND DUG FOR STONE.  
IRON PIN WAS 0.25' S AND 0.33' E OF CENTER OF  
STONE. (SEE PHOTO)

JULY 15, 2013

SET 1" SQUARE IRON PIN  
IN MONUMENT BOX OVER  
STONE

