

OTTAWA COUNTY ENGINEERS OFFICE

REFERENCE NO. 6-7-13-D
 WEST QUARTER POST SEC. 6
 ALLEN TWP.
 SHEET 1 OF 1.

ROUTE: C-2 FOSTORIA RD.
 @ T-74 YOUNG RD.

TOWNSHIP: ALLEN

SECTION: 6

T 7 N R 13 E.

PERSONNEL:

M. WITTMAN, P.S.
 J. ALLEN
 A. STAIB, WOOD CO.
 J. RACE
 K. TOMOR


NORTHING:

EASTING:

DATE / WEATHER / TEMP:

JUNE 21, 2023
 SUNNY
 83° F

DATUM:

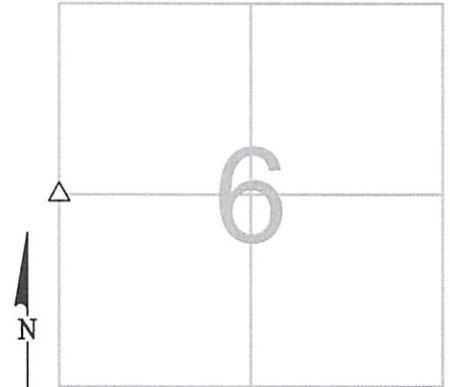

MONUMENT INFORMATION

MONUMENT TYPE: 7" x 5" TRIANGULAR STONE
 ON SURFACE - BELOW: 2.74'
LEFT - CL PAV'T - RIGHT: 4.0' FOSTORIA RD.
LEFT - CL PAV'T - RIGHT: 11.0' YOUNG RD.



MISC. INFORMATION

DIG LOCATION DETERMINED BY EXISTING TIES OF RECORD. FD RR SPIKES LAYING IN AREA ON WAY DOWN TO THE STONE.

THIS IS A CLOSING CORNER

