

OTTAWA COUNTY ENGINEERS OFFICE

REFERENCE NO. 6-7-13-E
CENTER POST SECTION 6
ALLEN TWP.
SHEET 1 OF 1.

ROUTE: T-74 YOUNG RD.

TOWNSHIP: ALLEN

SECTION: 6

T 7 NR 13 E.

PERSONNEL:

M. WITTMAN, P.S.
J. ALLEN
V. SZABO


NORTHING:

EASTING:

DATE / WEATHER / TEMP:

AUGUST 20, 2018
OVERCAST
74° F - HUMID

DATUM:

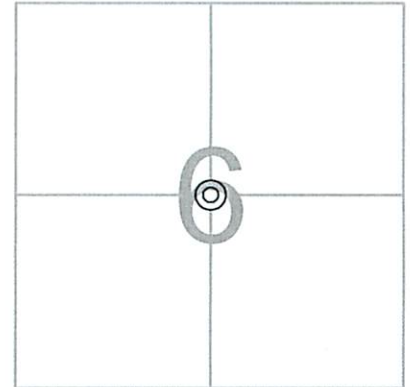

MONUMENT INFORMATION

MONUMENT TYPE: FD. CONCRETE MONUMENT
ON SURFACE - BELOW: 0.52'
LEFT - CL PAV'T - RIGHT: 8.15'

3/4" Ø BRASS PIN IN 6" Ø CONCRTE MONUMENT

CONCRETE MONUMENT PER 1972 YOUNG ROAD
DEDICATION PLAT



MISC. INFORMATION

FD. RR SPIKE ON SURFACE WHICH MATCHED TIES
FROM 1967. TIED W/ X-TIES AND DUG FOR
CONCRETE MONUMENT. CONCRETE MONUMENT
IS BROKEN, BUT BRASS PIN IS SOLID. RR SPIKE
WAS 0.03' NORTH AND 0.05' EAST BRASS PIN. SET
MONUMENT BOX OVER CONCRETE MONUMENT.

AUGUST 20, 2018

SET MONUMENT BOX OVER
CONCRETE MONUMENT

