

# OTTAWA COUNTY ENGINEERS OFFICE

REFERENCE NO. 6-7-13-H  
SOUTH QUARTER POST SEC. 6  
ALLEN TWP.  
SHEET 1 OF 1

ROUTE: C-68 WALBRIDGE EAST RD.

TOWNSHIP: ALLEN

SECTION: 6

T 7 NR 13 E.

PERSONNEL:  
M. WITTMAN, P.S.  
J. ALLEN


NORTHING:

EASTING:

DATE / WEATHER / TEMP:

JUNE 20, 2013  
SUNNY - SW  
74° F

DATUM:

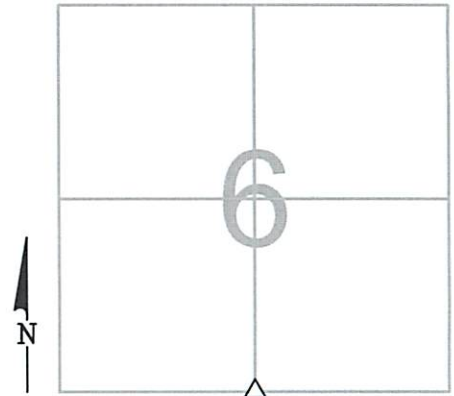

## MONUMENT INFORMATION

MONUMENT TYPE: 5" x 7" GRANITE STONE  
ON SURFACE - BELOW: 1.72'  
LEFT - CL PAV'T - RIGHT: 4.90'

S. 3-1/2" ARE HIGH AND N. 3-1/2" ARE LOW  
FD FAINT HOLE IN CENTER OF S. 3-1/2"  
SET AND USED DH IN FAINT HOLE ON STONE



## MISC. INFORMATION

PULLED REFERENCE TIES AND DUG FOR STONE.  
BELIEVE STEINMILLER FOUND AND LOCATED THE  
FAINT HOLE IN THE HIGH SOUTH 3-1/2" OF STONE  
AS IT MATCHED HIS LONG TIES.

JUNE 20, 2013

SE COR FDTN  
RES #24779

SET 1" SQUARE IRON PIN  
IN MONUMENT BOX OVER  
STONE

FD  
N&S

WALBRIDGE EAST RD., C.R. #68

