

# OTTAWA COUNTY ENGINEERS OFFICE

**REFERENCE NO.** 6-7-13-I  
 SE CORNER POST SEC. 6  
 ALLEN TWP.  
**SHEET** 1 OF 1.

**ROUTE:** C-68 WALBRIDGE EAST RD.  
 @ T- 54 BILLMAN RD.

**TOWNSHIP:** ALLEN

**SECTION:** 6


**T** 7 **NR** 13 **E.**

**PERSONNEL:**  
 M. WITTMAN, P.S.  
 J. ALLEN

**NORTHING:**

**EASTING:**

**DATUM:**

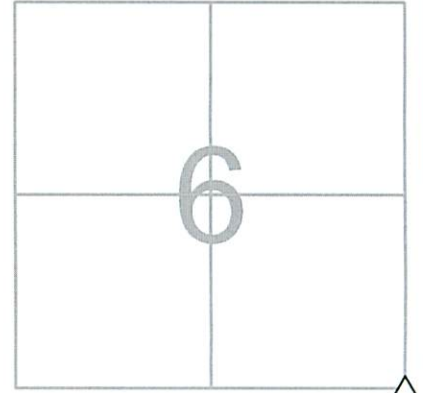

**DATE / WEATHER / TEMP:**  
 JUNE 24, 2013  
 SUNNY - S/SW  
 84° F

MONUMENT INFORMATION

MONUMENT TYPE: 8" x 10" ROUND STONE W/ DH  
 ON SURFACE - BELOW: 1.54'  
 LEFT - CL PAV'T - RIGHT: 4.80'

USED DRILL HOLE



MISC. INFORMATION

FD RR SPK 0.17' BELOW SURFACE, TIED W/ X-TIES  
 AND DUG FOR STONE. RR SPK WAS 0.05' EAST AND  
 0.04' NORTH OF DH IN STONE.

JUNE 24, 2013

SET 1" SQUARE IRON PIN  
 IN MONUMENT BOX OVER  
 STONE

