

# OTTAWA COUNTY ENGINEERS OFFICE


REFERENCE NO. 6-7-13-0  
 CENTER WEST 1/16 POST SEC. 6  
 ALLEN TWP.  
 SHEET 1 OF 1.

ROUTE: T-74 YOUNG RD.  
 TOWNSHIP: ALLEN  
 SECTION: 6  
 T 7 NR 13 E.

PERSONNEL:  
 M. WITTMAN, P.S.  
 J. ALLEN  
 V. SZABO

NORTHING:  
 EASTING:  
 DATUM:

DATE / WEATHER / TEMP:  
 AUGUST 18, 2018  
 OVERCAST W-SW  
 79° F - HUMID

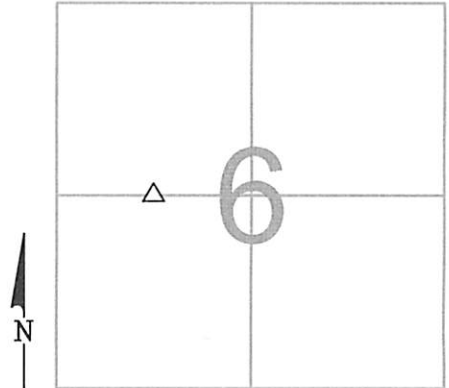

### MONUMENT INFORMATION

MONUMENT TYPE: FD. POINTED 5" x 5" STONE  
 ON SURFACE - BELOW: 1.70'  
 LEFT - CL PAV'T - RIGHT: 8.50'  
  
 STONE PER 1972 YOUNG ROAD DEDICATION PLAT



### MISC. INFORMATION

FD. RR SPIKE 0.23' BELOW SURFACE, TIED W/  
 X-TIES AND DUG FOR STONE. STONE FD. UNDER  
 SOUTH EDGE OF PAVEMENT. RR SPIKE WAS 1.44'  
 NORTH AND 1.07' WEST OF POINT USED ON  
 STONE.

AUGUST 15, 2018

SET 1" SQUARE IRON PIN  
 IN MONUMENT BOX OVER  
 STONE

CEN WELL CASING  
 24755 YOUNG RD

