


OTTAWA COUNTY ENGINEERS OFFICE

REFERENCE NO. 7-7-13-B
 NORTH QUARTER POST SEC. 7
 ALLEN TWP.
 SHEET 1 OF 1.

ROUTE: C-68 WALBRIDGE EAST RD.
 TOWNSHIP: ALLEN
 SECTION: 7
 T 7 NR 13 E.

PERSONNEL:
 M. WITTMAN, P.S.
 J. ALLEN

NORTHING:
 EASTING:
 DATUM:

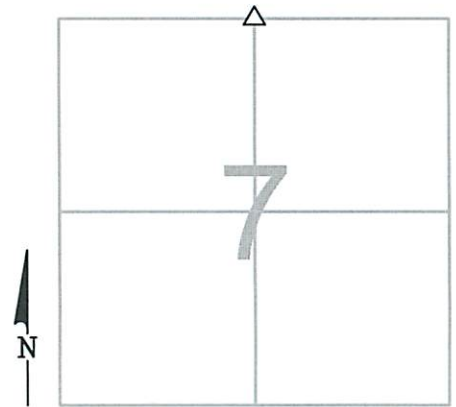

DATE / WEATHER / TEMP:
 JUNE 20, 2013
 SUNNY - SW
 74° F

MONUMENT INFORMATION

MONUMENT TYPE: 5" x 7" GRANITE STONE
 ON SURFACE - BELOW: 1.72'
 LEFT - CL PAV'T - RIGHT: 4.90'

S. 3-1/2" ARE HIGH AND N. 3-1/2" ARE LOW
 FD FAINT HOLE IN CENTER OF S. 3-1/2"
 SET AND USED DH IN FAINT HOLE ON STONE



MISC. INFORMATION

PULLED REFERENCE TIES AND DUG FOR STONE.
 BELIEVE STEINMILLER FOUND AND LOCATED THE
 FAINT HOLE IN THE HIGH SOUTH 3-1/2" OF STONE
 AS IT MATCHED HIS LONG TIES.

JUNE 20, 2013

SE COR FDTN
 RES #24779

SET 1" SQUARE IRON PIN
 IN MONUMENT BOX OVER
 STONE

