

OTTAWA COUNTY ENGINEERS OFFICE

REFERENCE NO. 7-7-13-D
 WEST QUARTER POST SEC. 7
 ALLEN TWP.
SHEET 1 OF 1.

ROUTE: C-2 FOSTORIA RD.

TOWNSHIP: ALLEN

SECTION: 7

T 7 **NR** 13 **E.**

PERSONNEL:

M. WITTMAN, P.S.
 J. ALLEN
 A. STAIB, WOOD COUNTY


NORTHING:

EASTING:

DATE / WEATHER / TEMP:

JULY 6, 2022
 SUNNY - N
 72° F

DATUM:

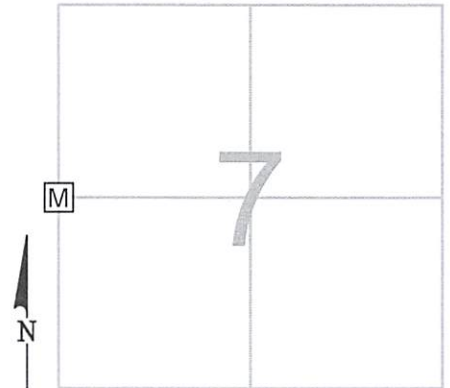

MONUMENT INFORMATION

MONUMENT TYPE: FD RR SPIKE PER RECORDS
 ON SURFACE - BELOW: 0.08'
LEFT - CL PAV'T - RIGHT: 6.4'

NO PHOTO AVAILABLE
 NO STONE FOUND

MISC. INFORMATION

FD RR SPK PER RECORDS, SHOT WITH GPS AND
 DUG FOR STONE. NO STONE WAS FOUND. SHOT
 POINT TO NORTH AND TO SOUTH AND THE RR SPK
 SHOT WAS GOOD FOR DISTANCE TO NORTH AND
 SOUTH. SINCE THIS IS A CLOSING CORNER SET A
 1" SQ. IRON PIN IN MON BOX IN PLACE OF RR SPK.

THIS IS A CLOSING CORNER

JULY 6, 2022

SET 1" SQUARE IRON PIN
 IN MONUMENT BOX

W 1/4 POST
 ALLEN TWP
 SEC 7

E 1/4 POST LAKE TWP,
 SEC 12, T 7N R12E
 FD IRON PIN

