

# OTTAWA COUNTY ENGINEERS OFFICE

REFERENCE NO. 8-7-13-B  
 NORTH QUARTER POST SEC. 8  
 ALLEN TWP.  
 SHEET 1 OF 1.

ROUTE: C-68 WALBRIDGE EAST RD.

TOWNSHIP: ALLEN

SECTION: 8

T 7 NR 13 E.


PERSONNEL:  
 M. WITTMAN, P.S.  
 J. ALLEN

NORTHING:

EASTING:

DATE / WEATHER / TEMP:  
 JUNE 27, 2013  
 OVERCAST - HUMID  
 76° F

DATUM:

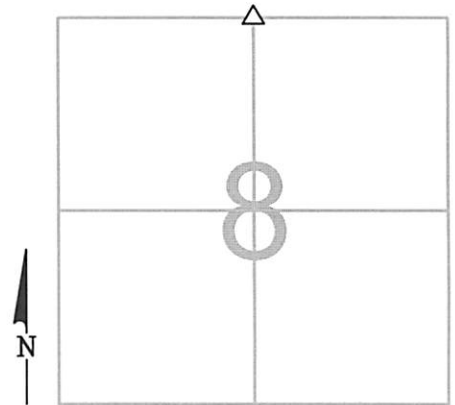

### MONUMENT INFORMATION

MONUMENT TYPE: FD. POINTED HARDHEAD STONE  
 ON SURFACE - BELOW: 1.47'  
 LEFT - CL PAV'T - RIGHT: 2.33'

4-1/2" x 4-1/4" x 4" ARROW SHAPED STONE  
 STONE IS POINTING NORTH  
 USED ARROW POINT OF STONE



### MISC. INFORMATION

FD HARROWTOOTH 0.53' BELOW SURFACE, TIED W/  
 X-TIES AND DUG FOR STONE. HARROW TOOTH  
 MATCHED POINT OF STONE USED EAST AND WEST  
 AND WAS 0.15' NORTH OF POINT.

JUNE 27, 2013  
 SET 1" SQUARE IRON PIN  
 IN MONUMENT BOX OVER  
 STONE

