

OTTAWA COUNTY ENGINEERS OFFICE

REFERENCE NO. 8-7-13-C
 NE CORNER POST SEC. 8
 ALLEN TWP.
SHEET 1 OF 1.

ROUTE: C-68 WALBRIDGE EAST RD.
 @ T-53 REIMAN RD.

TOWNSHIP: ALLEN

SECTION: 8

T 7 NR 13 E.


NORTHING:

EASTING:

DATUM:

PERSONNEL:
 M. WITTMAN, P.S.
 J. ALLEN

DATE / WEATHER / TEMP:
 JULY 15, 2013
 SUNNY - HUMID
 90° F

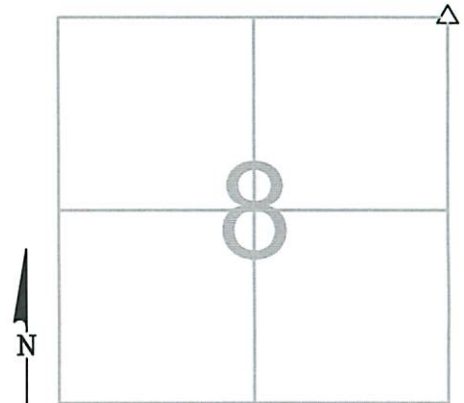

MONUMENT INFORMATION

MONUMENT TYPE: 8" x 8" RD POINTED LIMESTONE
 ON SURFACE - BELOW: 1.92'
LEFT - CL PAV'T - RIGHT: 1.15'

 USED CENTER OF STONE



MISC. INFORMATION

FD 1/2" Ø IRON PIN (CAPPED MARTIN) 0.11' BELOW
 SURFACE. TIED W/ X-TIES AND DUG FOR STONE.
 IRON PIN WAS 0.25' S AND 0.33' E OF CENTER OF
 STONE. (SEE PHOTO)

JULY 15, 2013

SET 1" SQUARE IRON PIN
 IN MONUMENT BOX OVER
 STONE

