

# OTTAWA COUNTY ENGINEERS OFFICE

REFERENCE NO. 8-7-13-D  
WEST QUARTER POST SEC. 8  
ALLEN TWP.  
SHEET 1 OF 1.

ROUTE: T-54 BILLMAN RD.

TOWNSHIP: ALLEN

SECTION: 8

T 7 NR 13 E.


PERSONNEL:  
M. WITTMAN, P.S.  
J. ALLEN  
K. BECK

NORTHING:

EASTING:


DATUM:

DATE / WEATHER / TEMP:  
JUNE 10, 2010  
SUNNY  
74° F

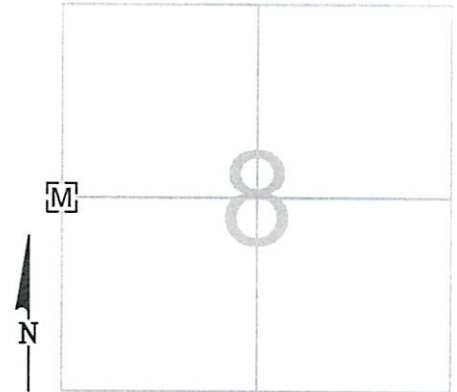

## MONUMENT INFORMATION

MONUMENT TYPE: FD. 1" SQ. IRON PIN IN MON. BOX  
ON SURFACE - BELOW: 0.25'  
LEFT - CL PAV'T - RIGHT: 2.50'

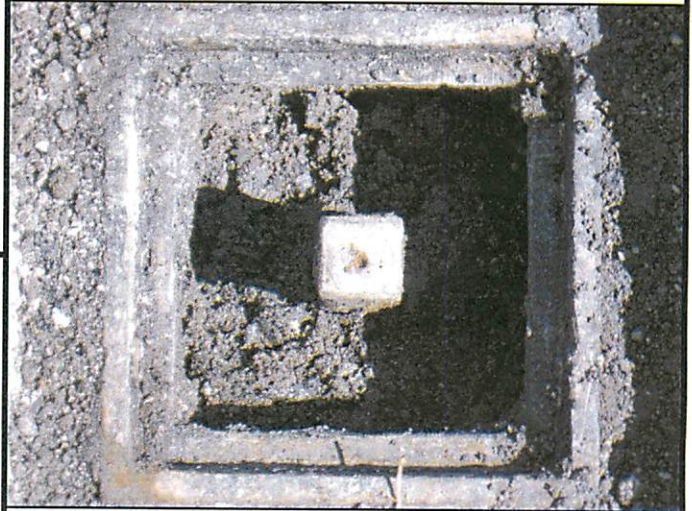

## MISC. INFORMATION

PLACED RISERS ON BOX TO BRING TO SURFACE.

