

OTTAWA COUNTY ENGINEERS OFFICE

REFERENCE NO. 8-7-13-I
SE CORNER SECTION 8
ALLEN TWP.
SHEET 1 OF 1.

ROUTE: T-53 REIMAN RD.
@ T-67 TROWBRIDGE RD.

TOWNSHIP: ALLEN

SECTION: 8

T 7 NR 13 E.


PERSONNEL:
M. WITTMAN, P.S.
J. ALLEN
S. ULLRICH

NORTHING:

EASTING:


DATUM:

DATE / WEATHER / TEMP:
AUGUST 26, 2008
SUNNY E
74° F

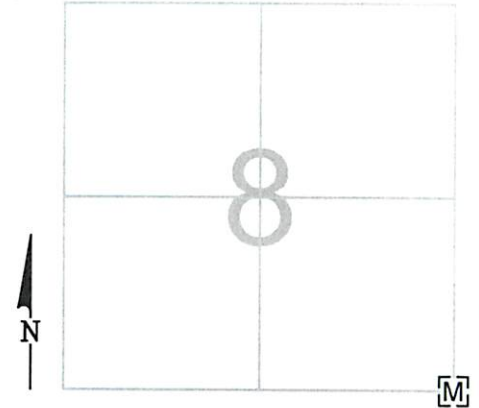

MONUMENT INFORMATION

MONUMENT TYPE: FD. 1"X 2" RECTANGULAR
IRON PIN IN MONUMENT BOX
ON SURFACE - BELOW: 0.25'
LEFT - CL PAV'T - RIGHT: 4.0' REIMAN RD.

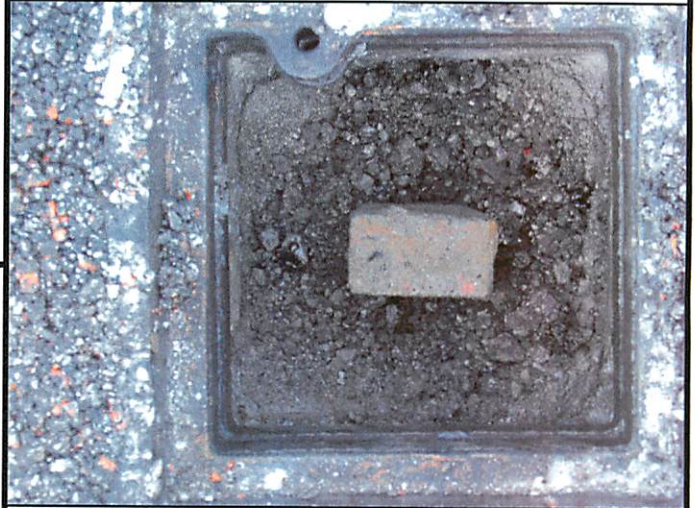

MISC. INFORMATION

1" = 2"
USED CENTER
OF PIN

