

OTTAWA COUNTY ENGINEERS OFFICE

REFERENCE NO. 9-7-13-C
NE CORNER POST SECTION 9
ALLEN TWP.
SHEET 1 OF 1.

ROUTE: C-51 GENOA CLAY CENTER RD.
@ T-68 WALBRIDGE EAST RD.

TOWNSHIP: ALLEN

SECTION: 9

T 7 N R 13 E.


NORTHING:

EASTING:

DATUM:

PERSONNEL:
M. WITTMAN, P.S.
M. BROUGH
R. LAJTI, JR.

DATE / WEATHER / TEMP:
JUNE 26, 2003
CLDY
70° F

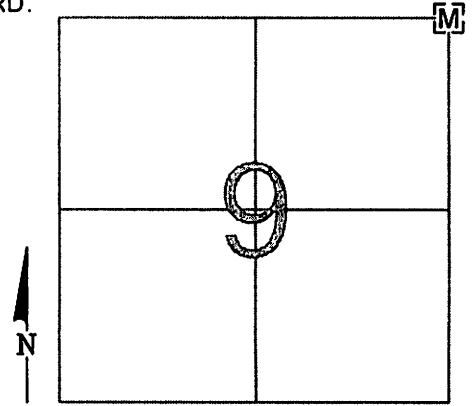

MONUMENT INFORMATION

MONUMENT TYPE: FD 1" SQ. IRON PIN IN MON BOX
ON SURFACE - BELOW:
LEFT - CL PAV'T - RIGHT:

MISC. INFORMATION

1" SQ. IRON PIN IN MONUMENT BOX SET 9-14-1971
STATION 210+58.55 - 1962 C.R. #51 PLANS

PHOTO OF STONE NOT AVAILABLE

