

OTTAWA COUNTY ENGINEERS OFFICE

REFERENCE NO. 9-7-13-F
E QUARTER POST SECTION 9
ALLEN TWP.
SHEET 1 OF 1.

ROUTE: C-51 GENOA CLAY CENTER RD.

TOWNSHIP: ALLEN

SECTION: 9

T 7 NR 13 E.

PERSONNEL:
M. WITTMAN, P.S.
M. BROUGH
R. LAJTI, JR.


NORTHING:

EASTING:

DATUM:

DATE / WEATHER / TEMP:

JUNE 26, 2003
CLDY
70° F

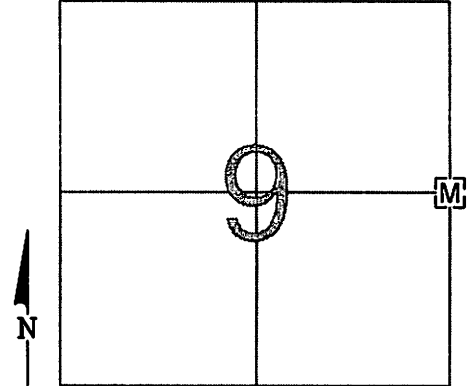

MONUMENT INFORMATION

MONUMENT TYPE: FD 1" SQ. IRON PIN IN MON BOX
ON SURFACE - BELOW:
LEFT - CL PAV'T - RIGHT:

MISC. INFORMATION

1" SQ. IRON PIN 9-21-1971, MONUMENT BOX SET
OVER PIN 9-23-1971

STATION 183+99.48 - 1962 C.R. #51 PLANS

PHOTO OF STONE NOT AVAILABLE

SHORT TIES

SET PK NAIL N - 2.00'
SET PK NAIL E - 2.00'
SET PK NAIL S - 2.00'

