

# OTTAWA COUNTY ENGINEERS OFFICE

**REFERENCE NO.** 1-6-16-G  
 SOUTHWEST CORNER SEC. 1  
 BAY TWP.  
**SHEET** 1 OF 1.

**ROUTE:** C-52 ON RAMP TO WB SR #2

**TOWNSHIP:** BAY

**SECTION:** 1

T 6 NR 16 E.

**PERSONNEL:**  
 M. WITTMAN, P.S.  
 J. ALLEN


**NORTHING:**

**EASTING:**

**DATUM:**

**DATE / WEATHER / TEMP:**

JULY 29, 2013  
 OVERCAST  
 70° F

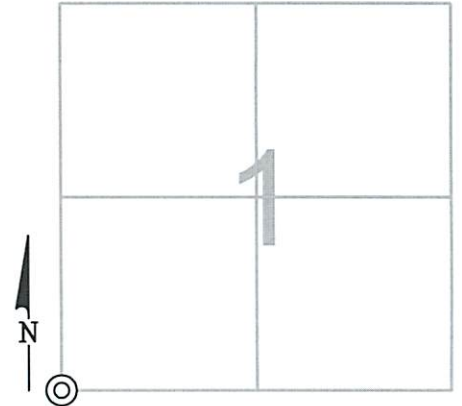

### MONUMENT INFORMATION

**MONUMENT TYPE:** FD BRASS DISK IN CONC IN CLAY TILE  
**ON SURFACE - BELOW:**  
**LEFT - CL PAV'T - RIGHT: 65.20'**



### MISC. INFORMATION

**NOTE:**  
 TIES ARE PLUMB  
 SHOT W/ GPS.

