

OTTAWA COUNTY ENGINEERS OFFICE

REFERENCE NO. 10-6-16-B
NORTH QUARTER POST SEC. 10
BAY TWP.
SHEET 1 OF 1.

ROUTE: T-124 SCHAU RD.

TOWNSHIP: BAY

SECTION: 10

T 6 NR 16 E.


PERSONNEL:
M. WITTMAN, P.S.
J. ALLEN
E. KOCH
C. MILLER

NORTHING:

EASTING:

DATUM:

DATE / WEATHER / TEMP:
AUGUST 4, 2009
SUNNY HUMID
78° F

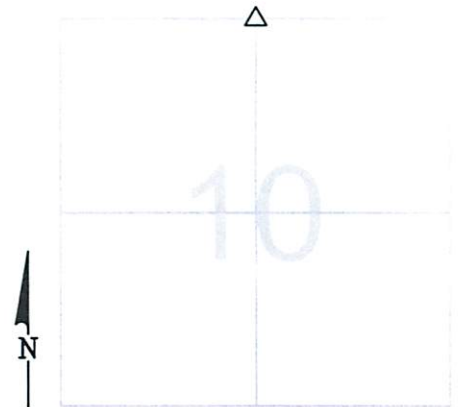

MONUMENT INFORMATION

MONUMENT TYPE: FD. SANDSTONE W/ DRILL HOLE
ON SURFACE - BELOW: 1.80'
LEFT - CL PAV'T - RIGHT: 3.80'
RECTANGULAR STONE: 6" x 10"

DRILL HOLE WAS IN A FAINT CHISELED "X".
USED DRILL HOLE.



MISC. INFORMATION

FD 1" Ø IRON PIPE 0.45' BELOW SURFACE. TIED W/
CROSS TIES AND DUG FOR STONE. IRON PIPE WAS
GOOD.

AUGUST 4, 2009

SET 1" SQUARE IRON PIN
IN MONUMENT BOX OVER
STONE

