

# OTTAWA COUNTY ENGINEERS OFFICE


REFERENCE NO. 10-6-16-C  
NE CORNER POST SECTION 10  
BAY TWP.  
SHEET 1 OF 1.

ROUTE: T-125 STREETER RD.  
TOWNSHIP: BAY  
SECTION: 10  
T 6 NR 16 E.

PERSONNEL:  
M. WITTMAN, P.S.  
J. ALLEN


NORTHING:  
EASTING:  
DATUM:

DATE / WEATHER / TEMP:  
APRIL 4, 2012  
SUNNY  
58° F

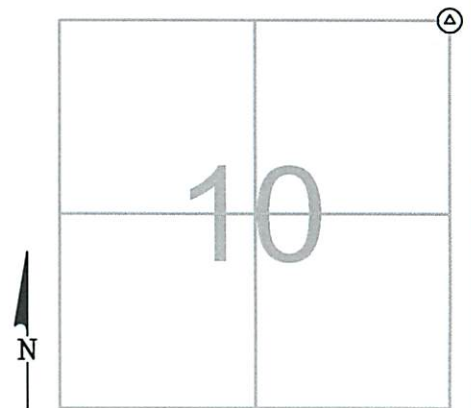

## MONUMENT INFORMATION

MONUMENT TYPE: FD. BRASS DISK IN CONC MON  
ON SURFACE - BELOW: 1.85'  
LEFT - CL PAV'T - RIGHT: 8.58'

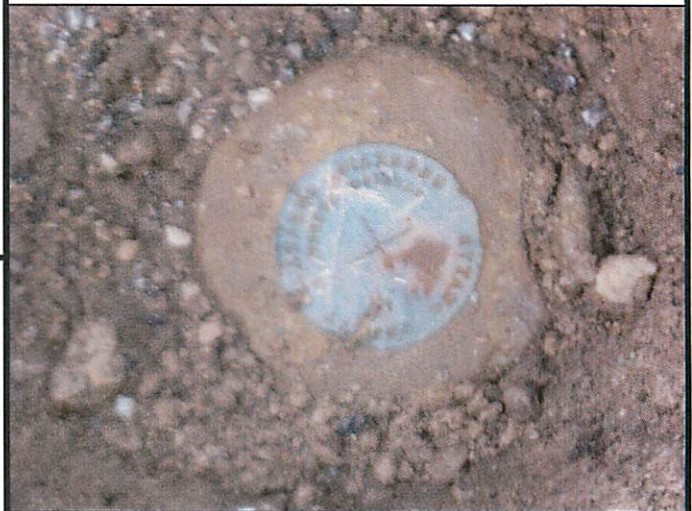

## MISC. INFORMATION

FD. BARN SPIKE W/ 2'-0" TIES NORTH, SOUTH AND  
WEST, DUG AND FOUND CONCRETE MONUMENT  
PER COUNTY RECORDS

APRIL 4, 2012

SET 1" SQUARE IRON PIN  
IN MONUMENT BOX OVER  
CONCRETE MONUMENT

