

OTTAWA COUNTY ENGINEERS OFFICE

REFERENCE NO. 11-6-16-C
NORTHEAST CORNER SEC. 11
BAY TWP.
SHEET 1 OF 1.

ROUTE: C-52 ON RAMP TO WB SR #2

TOWNSHIP: BAY

SECTION: 11

T 6 NR 16 E.

PERSONNEL:
M. WITTMAN, P.S.
J. ALLEN


NORTHING:

EASTING:

DATUM:

DATE / WEATHER / TEMP:

JULY 29, 2013
OVERCAST
70° F

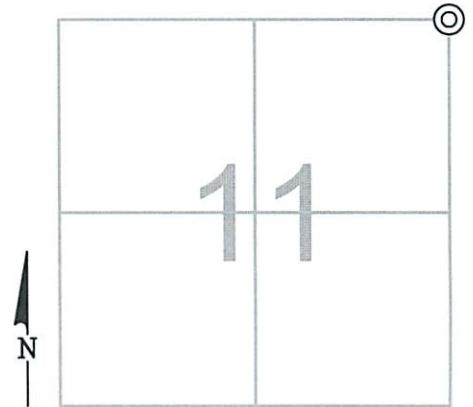

MONUMENT INFORMATION

MONUMENT TYPE: FD BRASS DISK IN CONC IN CLAY TILE
ON SURFACE - BELOW:
LEFT - CL PAV'T - RIGHT: 65.20'



MISC. INFORMATION

NOTE:
TIES ARE PLUMB
SHOT W/ GPS.

