

# OTTAWA COUNTY ENGINEERS OFFICE

REFERENCE NO. 11-6-16-E  
CENTER POST SEC. 11  
BAY TWP.  
SHEET 1 OF 1.

PERSONNEL:  
M. WITTMAN, P.S.  
J. ALLEN

DATE / WEATHER / TEMP:  
MAY 11, 2020  
CLOUDY, W - SW  
50° F

ROUTE: T-117 HYDE RD.

TOWNSHIP: BAY


SECTION: 11

T 6 NR 16 E.

NORTHING:

EASTING:

DATUM:

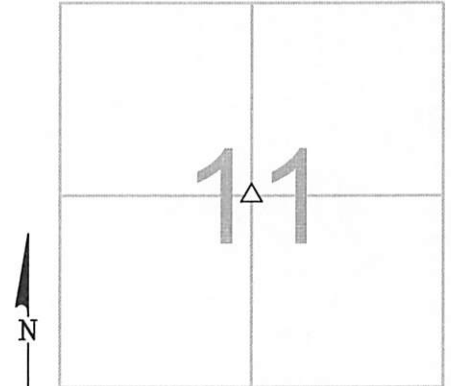

## MONUMENT INFORMATION

MONUMENT TYPE: FD. LIMESTONE  
ON SURFACE - BELOW: 2.59'  
LEFT - CL PAV'T - RIGHT: 1.00'

4 1/2" x 4 1/2" ROUND POINTED LIMESTONE  
USED CENTER OF STONE



## MISC. INFORMATION

FD. 4" DIAMETER SEWER PIPE ON SURFACE, TIED  
W/ X-TIES AND DUG FOR STONE. CENTER OF  
SEWER PIPE WAS 0.03' SOUTH AND 0.35' WEST OF  
CENTER OF STONE.

MAY 11, 2020

SET 1" SQUARE IRON PIN  
IN MONUMENT BOX OVER  
STONE

