

OTTAWA COUNTY ENGINEERS OFFICE

REFERENCE NO. 12-6-16-A
 NORTHWEST CORNER SEC. 12
 BAY TWP.
SHEET 1 OF 1.

PERSONNEL:
 M. WITTMAN, P.S.
 J. ALLEN

DATE / WEATHER / TEMP:
 JULY 29, 2013
 OVERCAST
 70° F

ROUTE: C-52 ON RAMP TO WB SR #2

TOWNSHIP: BAY


SECTION: 12

T 6 NR 16 E.

NORTHING:

EASTING:

DATUM:

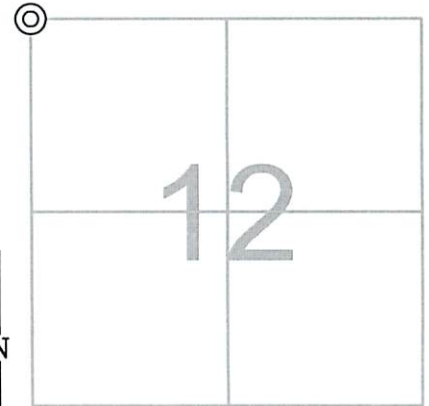

MONUMENT INFORMATION

MONUMENT TYPE: FD BRASS DISK IN CONC IN CLAY TILE
ON SURFACE - BELOW:
LEFT - CL PAV'T - RIGHT: 65.20'



MISC. INFORMATION

NOTE:
 TIES ARE PLUMB
 SHOT W/ GPS.

