

OTTAWA COUNTY ENGINEERS OFFICE

REFERENCE NO. 13-6-16-A
NORTHWEST CORNER SEC. 13
BAY TWP.
SHEET 1 OF 1.

PERSONNEL:
M. WITTMAN, P.S.
J. ALLEN

DATE / WEATHER / TEMP:
JULY 29, 2013
PTLY SUNNY
67° F

ROUTE: T-118 WONNELL RD.

TOWNSHIP: BAY


SECTION: 13

T 6 NR 16 E.

NORTHING:

EASTING:

DATUM:

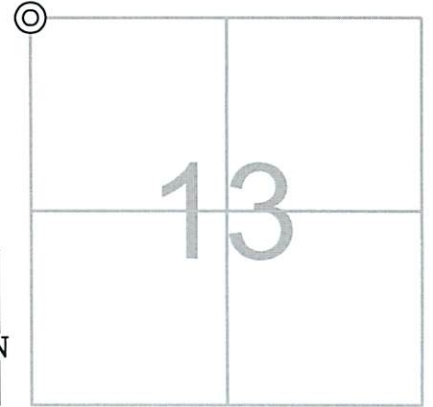

MONUMENT INFORMATION

MONUMENT TYPE: FD BRASS DISK IN CONCRETE
ON SURFACE - BELOW: 0.45'
LEFT - CL PAV'T - RIGHT: 20.50'

SET ORANGE DELINEATOR 1' WEST OF MONUMENT



MISC. INFORMATION

