

OTTAWA COUNTY ENGINEERS OFFICE

REFERENCE NO. 14-6-16-C
NORTHEAST CORNER SEC. 14
BAY TWP.
SHEET 1 OF 1.

ROUTE: T-118 WONNELL RD.

TOWNSHIP: BAY

SECTION: 14

T 6 NR 16 E.

PERSONNEL:
M. WITTMAN, P.S.
J. ALLEN


NORTHING:

EASTING:

DATUM:

DATE / WEATHER / TEMP:

JULY 29, 2013
PTLY SUNNY
67° F

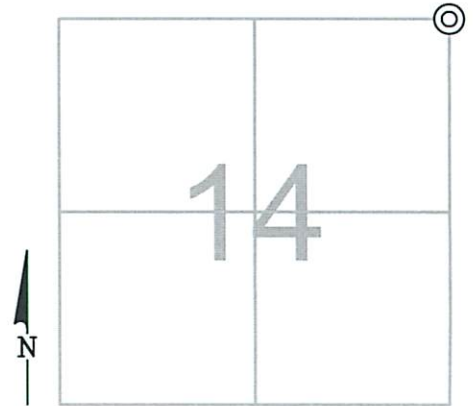

MONUMENT INFORMATION

MONUMENT TYPE: FD BRASS DISK IN CONCRETE
ON SURFACE - BELOW: 0.45'
LEFT - CL PAV'T - RIGHT: 20.50'

SET ORANGE DELINEATOR 1' WEST OF MONUMENT



MISC. INFORMATION

