

OTTAWA COUNTY ENGINEERS OFFICE


REFERENCE NO. 16-6-16-B
NORTH QUARTER POST SEC. 16
BAY TWP.
SHEET 1 OF 1.

ROUTE: C-17 OAK HARBOR SOUTHEAST RD.
TOWNSHIP: BAY
SECTION: 16
T 6 NR 16 E.

PERSONNEL:
M. WITTMAN, P.S.
J. ALLEN

NORTHING:
EASTING:
DATUM:

DATE / WEATHER / TEMP:
JUNE 18, 2012
SUNNY - S
80° F

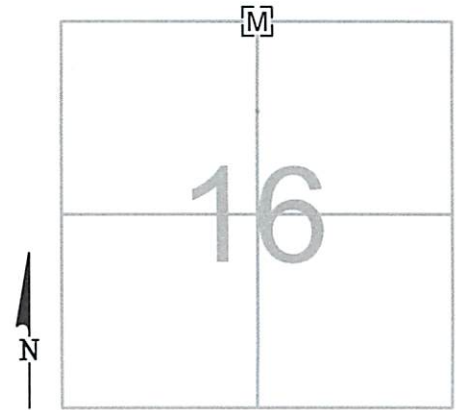

MONUMENT INFORMATION

MONUMENT TYPE: FD 1" SQ IRON PIN IN MON BOX
ON SURFACE - BELOW: 0.35'
LEFT - CL PAV'T - RIGHT:



MISC. INFORMATION

