

OTTAWA COUNTY ENGINEERS OFFICE


REFERENCE NO. 16-6-16-C
 NORTHEAST CORNER SEC. 16
 BAY TWP.
SHEET 1 OF 1.

ROUTE: C-17 OAK HARBOR SOUTHEAST RD.
TOWNSHIP: BAY
SECTION: 16
T 6 **NR** 16 **E.**

PERSONNEL:
 M. WITTMAN, P.S.
 J. ALLEN

NORTHING:
EASTING:
DATUM:

DATE / WEATHER / TEMP:
 JUNE 18, 2012
 SUNNY - S
 79° F

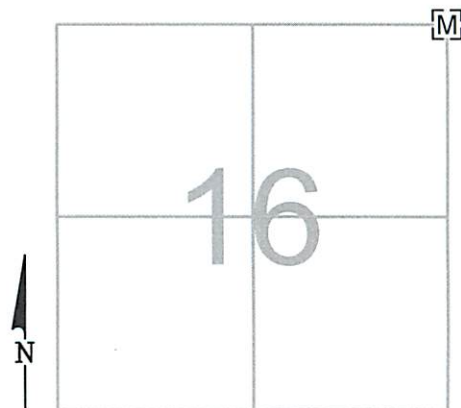

MONUMENT INFORMATION

MONUMENT TYPE: FD 1" SQ IRON PIN IN MON BOX
 ON SURFACE - BELOW: 0.10'
 LEFT - CL PAV'T - RIGHT:
 DRILL HOLE IN IRON PIN



MISC. INFORMATION

IRON PIN IS ALMOST AGAINST WEST SIDE OF
 MONUMENT BOX

