

OTTAWA COUNTY ENGINEERS OFFICE

REFERENCE NO. 16-6-16-D
WEST QUARTER POST SEC. 16
BAY TWP.
SHEET 1 OF 1.

PERSONNEL:
M. WITTMAN, P.S.
J. ALLEN

DATE / WEATHER / TEMP:
MAY 18, 2017
SUNNY - SW
78° F

ROUTE: T-112 LITTLE-PORTAGE EAST RD.

TOWNSHIP: BAY


SECTION: 16

T 6 NR 16 E.

NORTHING:

EASTING:

DATUM:

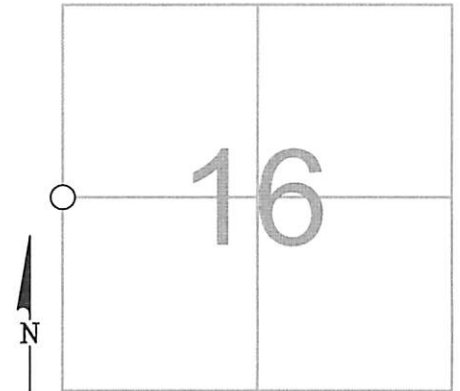

MONUMENT INFORMATION

MONUMENT TYPE: FD. 1" Ø IRON PIN
ON SURFACE - BELOW: 0.34'
LEFT - CL PAV'T - RIGHT: 2.00'

IRON PIN PER COUNTY RECORDS SET: 10-3-1961.



MISC. INFORMATION

MAY 22, 2017

FD. SET MONUMENT BOX OVER
FD. 1" Ø IRON PIN

