

# OTTAWA COUNTY ENGINEERS OFFICE

REFERENCE NO. 17-6-16-B  
NORTH QUARTER POST SEC. 17  
BAY TWP.  
SHEET 1 OF 1.

ROUTE: C-17 OAK HARBOR SOUTHEAST RD.

TOWNSHIP: BAY

SECTION: 17

T 6 NR 16 E.

**PERSONNEL:**

M. WITTMAN, P.S.  
J. ALLEN


NORTHING:

EASTING:

**DATE / WEATHER / TEMP:**

JUNE 18, 2012  
SUNNY - SW  
93° F

DATUM:

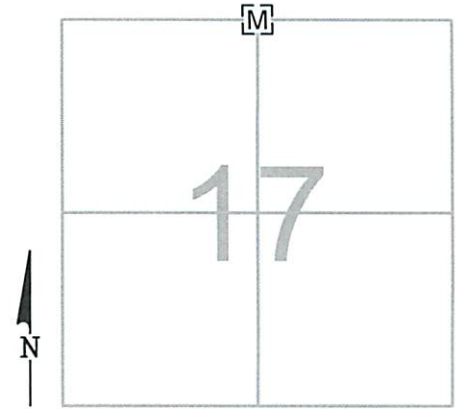

MONUMENT INFORMATION

MONUMENT TYPE: 1" SQ. IRON PIN IN MON BOX  
ON SURFACE - BELOW: 0.30'  
LEFT - CL PAV'T - RIGHT:



MISC. INFORMATION

