

OTTAWA COUNTY ENGINEERS OFFICE

REFERENCE NO. 17-6-16-C
NORTHEAST CORNER SEC. 17
BAY TWP.
SHEET 1 OF 1.

PERSONNEL:
M. WITTMAN, P.S.
J. ALLEN

DATE / WEATHER / TEMP:
JUNE 18, 2012
SUNNY - S
88° F

ROUTE: C-17 OAK HARBOR SOUTHEAST RD.

TOWNSHIP: BAY


SECTION: 17

T 6 NR 16 E.

NORTHING:

EASTING:

DATUM:

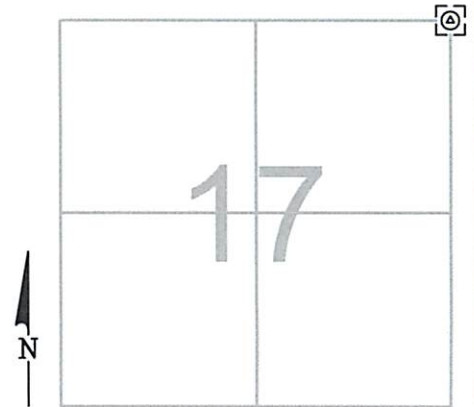

MONUMENT INFORMATION

MONUMENT TYPE: FD 3-1/4" Ø BRASS DISK IN MON BOX
ON SURFACE - BELOW:
LEFT - CL PAV'T - RIGHT: 0.50'



MISC. INFORMATION

