

# OTTAWA COUNTY ENGINEERS OFFICE

REFERENCE NO. 17-6-16-D  
 WEST QUARTER POST SEC. 17  
 BAY TWP.  
 SHEET 1 OF 1.

ROUTE: T-112 LITTLE-PORTAGE EAST RD.  
 @ T-114 PAULSEN RD.

TOWNSHIP: BAY

SECTION: 17

T 6 NR 16 E.


PERSONNEL:  
 M. WITTMAN, P.S.  
 J. ALLEN

NORTHING:

EASTING:

DATE / WEATHER / TEMP:  
 MAY 22, 2017  
 SUNNY - S-SW  
 56° F

DATUM:

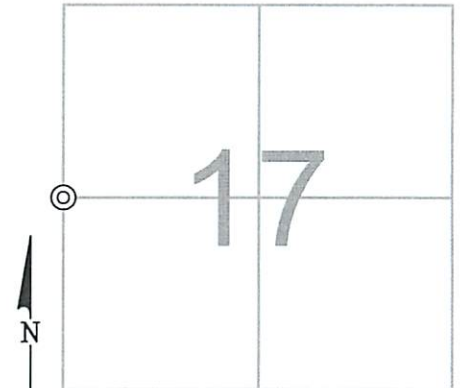

### MONUMENT INFORMATION

MONUMENT TYPE: FD. 1-1/2" I.D. IRON PIPE  
 ON SURFACE - BELOW: 1.30'  
 LEFT - CL PAV'T - RIGHT: 1.75' LITTLE-PORTAGE EAST RD.  
 LEFT - CL PAV'T - RIGHT: 1.00' PAULSEN RD.  
 IRON PIPE OF RECORD IN STONE BOOK.



### MISC. INFORMATION

MAY 22, 2017

SET 1" SQUARE IRON PIN  
 IN MONUMENT BOX OVER  
 IRON PIPE

