

# OTTAWA COUNTY ENGINEERS OFFICE

REFERENCE NO. 17-6-16-E  
CENTER POST SEC. 17  
BAY TWP.  
SHEET 1 OF 1.

PERSONNEL:  
M. WITTMAN, P.S.  
J. ALLEN

DATE / WEATHER / TEMP:  
MAY 18, 2017  
SUNNY - SW  
91° F

ROUTE: T-112 LITTLE-PORTAGE EAST RD.

TOWNSHIP: BAY


SECTION: 17

T 6 NR 16 E.

NORTHING:

EASTING:

DATUM:

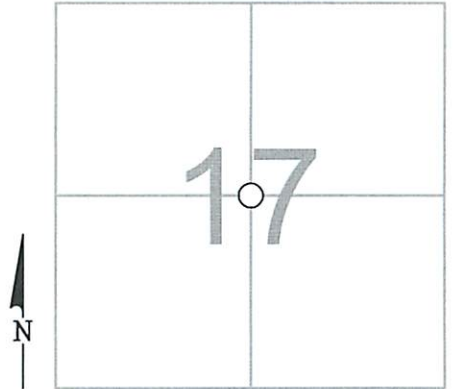

## MONUMENT INFORMATION

MONUMENT TYPE: FD. 1" SQUARE IRON PIN  
ON SURFACE - BELOW: 0.77'  
LEFT - CL PAV'T - RIGHT: 14.20'

IRON PIN IS 4.70' SOUTH OF SOUTH EDGE OF  
PAVEMENT.



## MISC. INFORMATION

MAY 22, 2017

FD. 1" SQUARE IRON PIN

