

# OTTAWA COUNTY ENGINEERS OFFICE

REFERENCE NO. 17-6-16-K  
N 1/4 POST NORTHEAST 1/4 SEC. 17  
BAY TWP.  
SHEET 1 OF 1.

ROUTE: C-17 OAK HARBOR SOUTHEAST RD.

TOWNSHIP: BAY

SECTION: 17

T 6 NR 16 E.

PERSONNEL:  
M. WITTMAN, P.S.  
J. ALLEN


NORTHING:

EASTING:

DATUM:

DATE / WEATHER / TEMP:

JUNE 18, 2012  
SUNNY - S-SW  
92° F

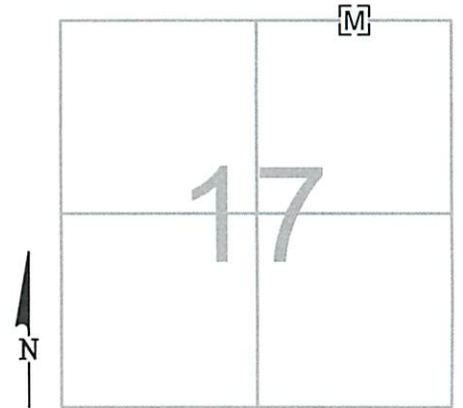

## MONUMENT INFORMATION

MONUMENT TYPE: FD 1-1/4" SQ IRON PIN IN MON BOX  
ON SURFACE - BELOW:  
LEFT - CL PAV'T - RIGHT: 1.00'



## MISC. INFORMATION

