

OTTAWA COUNTY ENGINEERS OFFICE

REFERENCE NO. 18-6-16-A
 NW CORNER POST SECTION 18
 BAY TWP.
SHEET 1 OF 1.

ROUTE: C-17 OAK HARBOR SE RD.
 @ SALEM / BAY TWP. LINE

TOWNSHIP: BAY


SECTION: 18

T 6 NR 16 E.

NORTHING:

EASTING:

DATUM:

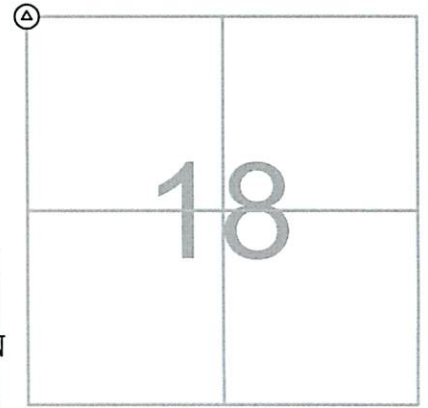

PERSONNEL:
 M. WITTMAN, P.S.
 J. ALLEN

DATE / WEATHER / TEMP:
 JUNE 17, 2014
 SUNNY, SW
 94° F

MONUMENT INFORMATION

MONUMENT TYPE: FD. BRASS DISK IN CONCRETE
 ON SURFACE - BELOW: 1.5'
LEFT - CL PAV'T - RIGHT: 78.6'

 SET ORANGE DELINEATOR 1.5' NORTH OF
 MONUMENT.



MISC. INFORMATION

MONUMENT IS IN NORTH BANK OF DITCH WHERE
 DITCH TURNS FROM EAST TO NORTH.

THIS IS A CLOSING CORNER.

NOTE:
 ALL TIES ARE PLUMB AS
 THEY WERE SHOT W/ GPS.

