

OTTAWA COUNTY ENGINEERS OFFICE

REFERENCE NO. 18-6-16-C
NORTHEAST CORNER SEC. 18
BAY TWP.
SHEET 1 OF 1.

ROUTE: C-17 OAK HARBOR SOUTHEAST RD.

TOWNSHIP: BAY

SECTION: 18

T 6 NR 16 E.

PERSONNEL:
M. WITTMAN, P.S.
J. ALLEN


NORTHING:

EASTING:

DATE / WEATHER / TEMP:

JUNE 19, 2012
SUNNY - W
83° F

DATUM:

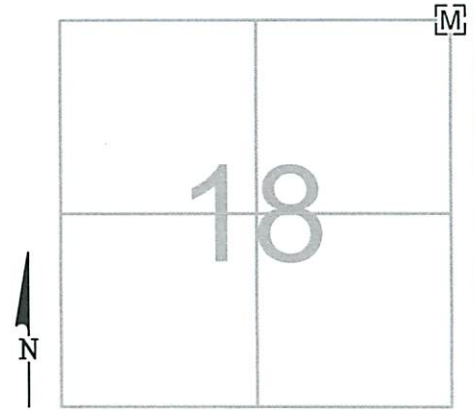

MONUMENT INFORMATION

MONUMENT TYPE: FD 5/8" Ø IRON PIN IN MON BOX
ON SURFACE - BELOW: 0.26'
LEFT - CL PAV'T - RIGHT: 3.30'



MISC. INFORMATION

OAK HARBOR SOUTHEAST RD., C.R. #17

