

OTTAWA COUNTY ENGINEERS OFFICE

REFERENCE NO. 18-6-16-E
 CENTER POST SEC. 18
 BAY TWP.
 SHEET 1 OF 1.

ROUTE: T-112 LITTLE-PORTAGE EAST RD.

TOWNSHIP: BAY

SECTION: 18

T 6 NR 16 E.


PERSONNEL:
 M. WITTMAN, P.S.
 J. ALLEN

NORTHING:

EASTING:

DATE / WEATHER / TEMP:
 MAY 22, 2017
 SUNNY - S-SW
 62° F

DATUM:

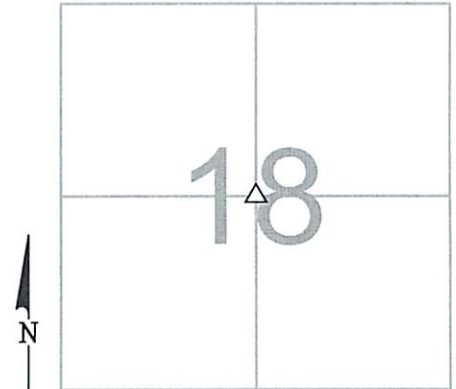

MONUMENT INFORMATION

MONUMENT TYPE: FD. HARDHEAD STONE
 ON SURFACE - BELOW: 1.63'
 LEFT - CL PAV'T - RIGHT: 2.50'

8" X 8" X 6" HARDHEAD WITH NO VISIBLE
 MARKINGS, SET DRILL HOLE IN CENTER OF
 STONE.



MISC. INFORMATION

1-19-2012 - M.WITTMAN - OCE, P. SEGAARD, P.S. BEC, J.
 HAYES BEC, M. POMMERANZ BEC - FD RR SPIKE 0.40'
 BELOW SURFACE, TIED W/ 4'-0" TIES E & S AND DUG FOR
 STONE. DID NOT FIND STONE, DUG FURTHER WEST AND
 NORTH. FD 5/8" BOLT 5" LONG 1.15' BELOW SURFACE.
 FOUND STONE BELOW BOLT. RR SPIKE WAS 1.10' EAST
 AND 0.55' SOUTH OF DRILL HOLE SET IN CENTER OF
 STONE. SET MAG SPIKE IN PATCH OVER STONE W/
 2'-0" TIES N,S,E & W.

MAY 22, 2017

SET 1" SQUARE IRON PIN
 IN MONUMENT BOX OVER
 STONE

