

OTTAWA COUNTY ENGINEERS OFFICE

REFERENCE NO. 18-6-16-F
EAST QUARTER POST SEC. 18
BAY TWP.
SHEET 1 OF 1.

PERSONNEL:
M. WITTMAN, P.S.
J. ALLEN

DATE / WEATHER / TEMP:
MAY 22, 2017
SUNNY - S-SW
56° F

ROUTE: T-112 LITTLE-PORTAGE EAST RD.
@ T-114 PAULSEN RD.

TOWNSHIP: BAY


SECTION: 18

T 6 NR 16 E.

NORTHING:

EASTING:

DATUM:

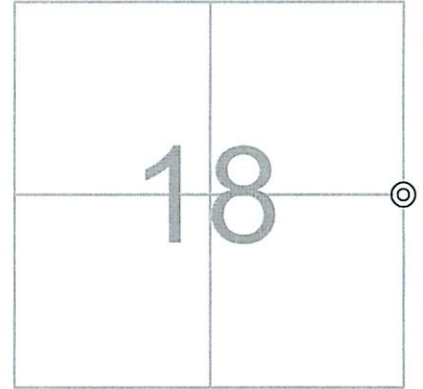

MONUMENT INFORMATION

MONUMENT TYPE: FD. 1-1/2" I.D. IRON PIPE
ON SURFACE - BELOW: 1.30'
LEFT - CL PAV'T - RIGHT: 1.75' LITTLE-PORTAGE EAST RD.
LEFT - CL PAV'T - RIGHT: 1.00' PAULSEN RD.

IRON PIPE OF RECORD IN STONE BOOK.



MISC. INFORMATION

MAY 22, 2017

SET 1" SQUARE IRON PIN
IN MONUMENT BOX OVER
IRON PIPE

