

# OTTAWA COUNTY ENGINEERS OFFICE

REFERENCE NO. 18-6-16-1  
 SE CORNER POST SEC. 18  
 BAY TWP.  
 SHEET 1 OF 1.

ROUTE: C-114 PAULSEN RD.

TOWNSHIP: BAY

SECTION: 18

T 6 N R 16 E.


PERSONNEL:  
 M. WITTMAN, P.S.  
 J. ALLEN

NORTHING:

EASTING:

DATE / WEATHER / TEMP:  
 MAY 15, 2017  
 SUNNY - SE  
 75° F

DATUM:

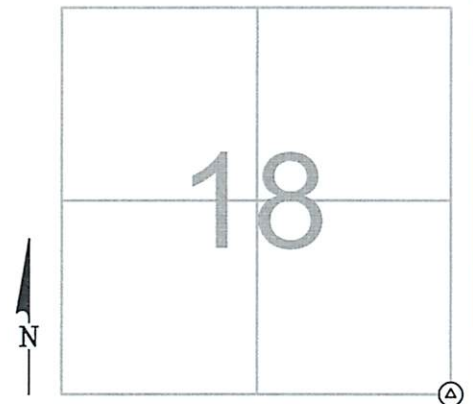

### MONUMENT INFORMATION

MONUMENT TYPE: FD. 3-1/2" Ø BRASS DISK  
 ON SURFACE - BELOW: 1.61'  
 LEFT - CL PAV'T - RIGHT: 0.35'

BRASS OTTAWA COUNTY OHIO GEODETIC  
 SURVEY DISK IN 6" Ø CONCRETE MONUMENT.



### MISC. INFORMATION

FD RR SPIKE 0.57' BELOW SURFACE. TIED W/  
 X-TIES AND DUG FOR STONE.  
 FD 3/4" Ø IRON PIN SLANTED NORTHERLY OVER  
 MONUMENT. TOP OF SLANT PIN WAS OVER  
 CENTER OF MONUMENT. RR SPIKE WAS 0.08'  
 WEST AND 0.08' SOUTH OF "+" ON BRASS DISK.

MAY 15, 2017

SET 1" SQUARE IRON PIN IN  
 MONUMENT BOX OVER FOUND  
 BRASS DISK IN CONCRETE.

