

OTTAWA COUNTY ENGINEERS OFFICE

REFERENCE NO. 19-6-16-F
EAST QUARTER POST SEC. 19
BAY TWP.

SHEET 1 OF 1.

PERSONNEL:
M. WITTMAN, P.S.
J. ALLEN

DATE / WEATHER / TEMP:
MAY 15, 2017
SUNNY
71° F

ROUTE: C-114 PAULSEN RD.
@ C-113 BOYSEN RD.

TOWNSHIP: BAY


SECTION: 19

T 6 NR 16 E.

NORTHING:

EASTING:

DATUM:

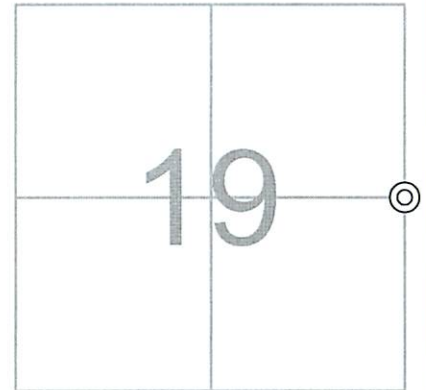

MONUMENT INFORMATION

MONUMENT TYPE: FD. 1" SQ IRON PIN
ON SURFACE - BELOW: 0.66'
LEFT - CL PAV'T - RIGHT: 2.55' PAULSEN ROAD
LEFT - CL PAV'T - RIGHT: 1.30' BOYSEN ROAD

IRON PIN IN 6" Ø CLAY TILE.



MISC. INFORMATION

FD RR SPIKE 0.52' BELOW SURFACE. TIED W/
X-TIES AND DUG FOR STONE.
RR SPIKE WAS 0.08' SOUTH AND 0.03' WEST OF
CENTER OF IRON PIN.

MAY 15, 2017

SET MONUMENT BOX OVER
FOUND 1" SQUARE IRON PIN
IN CLAY TILE.

