

OTTAWA COUNTY ENGINEERS OFFICE

REFERENCE NO. 20-6-16-A
 NW CORNER POST SEC. 20
 BAY TWP.
 SHEET 1 OF 1.

ROUTE: C-114 PAULSEN RD.

TOWNSHIP: BAY


SECTION: 20

T 6 NR 16 E.

NORTHING:

EASTING:

DATUM:

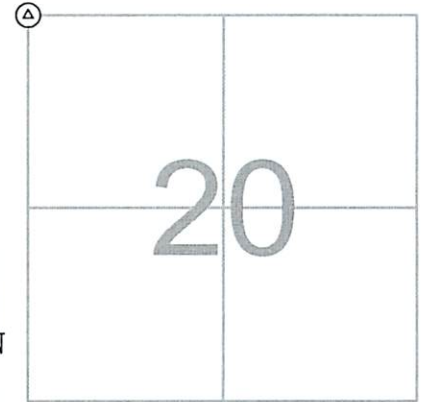

PERSONNEL:
 M. WITTMAN, P.S.
 J. ALLEN

DATE / WEATHER / TEMP:
 MAY 15, 2017
 SUNNY - SE
 75° F

MONUMENT INFORMATION

MONUMENT TYPE: FD. 3-1/2" Ø BRASS DISK
 ON SURFACE - BELOW: 1.61'
 LEFT - CL PAV'T - RIGHT: 0.35'

BRASS OTTAWA COUNTY OHIO GEODETIC
 SURVEY DISK IN 6" Ø CONCRETE MONUMENT.



MISC. INFORMATION

FD RR SPIKE 0.57' BELOW SURFACE. TIED W/
 X-TIES AND DUG FOR STONE.
 FD 3/4" Ø IRON PIN SLANTED NORTHERLY OVER
 MONUMENT. TOP OF SLANT PIN WAS OVER
 CENTER OF MONUMENT. RR SPIKE WAS 0.08'
 WEST AND 0.08' SOUTH OF "+" ON BRASS DISK.

MAY 15, 2017

SET 1" SQUARE IRON PIN IN
 MONUMENT BOX OVER FOUND
 BRASS DISK IN CONCRETE.

