

OTTAWA COUNTY ENGINEERS OFFICE

REFERENCE NO. 20-6-16-D
 WEST QUARTER POST SEC. 20
 BAY TWP.
SHEET 1 OF 1.

ROUTE: C-114 PAULSEN RD.
 @ C-113 BOYSEN RD.

TOWNSHIP: BAY

SECTION: 20

T 6 **NR** 16 **E.**


PERSONNEL:
 M. WITTMAN, P.S.
 J. ALLEN

NORTHING:

EASTING:

DATE / WEATHER / TEMP:
 MAY 15, 2017
 SUNNY
 71° F

DATUM:

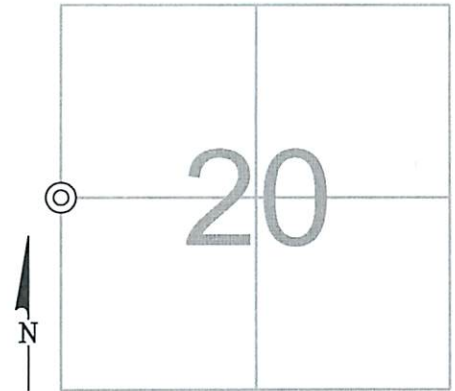

MONUMENT INFORMATION

MONUMENT TYPE: FD. 1" SQ IRON PIN
 ON SURFACE - BELOW: 0.66'
LEFT - CL PAV'T - RIGHT: 2.55' PAULSEN ROAD
LEFT - CL PAV'T - RIGHT: 1.30' BOYSEN ROAD

 IRON PIN IN 6" Ø CLAY TILE.



MISC. INFORMATION

FD RR SPIKE 0.52' BELOW SURFACE. TIED W/
 X-TIES AND DUG FOR STONE.
 RR SPIKE WAS 0.08' SOUTH AND 0.03' WEST OF
 CENTER OF IRON PIN.

MAY 15, 2017

SET MONUMENT BOX OVER
 FOUND 1" SQUARE IRON PIN
 IN CLAY TILE.

