

OTTAWA COUNTY ENGINEERS OFFICE

REFERENCE NO. 3-6-16-I
SE CORNER POST SECTION 3
BAY TWP.
SHEET 1 OF 1.

ROUTE: T-125 STREETER RD.

TOWNSHIP: BAY

SECTION: 3

T 6 NR 16 E.

PERSONNEL:
M. WITTMAN, P.S.
J. ALLEN


NORTHING:

EASTING:

DATUM:

DATE / WEATHER / TEMP:

APRIL 4, 2012
SUNNY
58° F

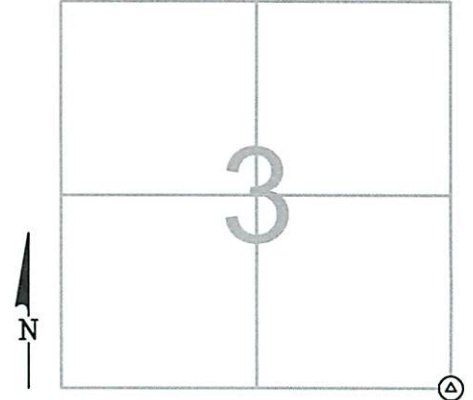

MONUMENT INFORMATION

MONUMENT TYPE: FD. BRASS DISK IN CONC MON
ON SURFACE - BELOW: 1.85'
LEFT - CL PAV'T - RIGHT: 8.58'



MISC. INFORMATION

FD. BARN SPIKE W/ 2'-0" TIES NORTH, SOUTH AND
WEST, DUG AND FOUND CONCRETE MONUMENT
PER COUNTY RECORDS

APRIL 4, 2012

SET 1" SQUARE IRON PIN
IN MONUMENT BOX OVER
CONCRETE MONUMENT

