

OTTAWA COUNTY ENGINEERS OFFICE

REFERENCE NO. 7-6-16-G
SW CORNER POST SECTION 7
BAY TWP.
SHEET 1 OF 1.

ROUTE: C-17 OAK HARBOR SE RD.
@ SALEM / BAY TWP. LINE

TOWNSHIP: BAY

SECTION: 7

T 6 NR 16 E.

NORTHING:


EASTING:

DATUM:

PERSONNEL:
M. WITTMAN, P.S.
J. ALLEN

DATE / WEATHER / TEMP:

JUNE 17, 2014
SUNNY, SW
94° F

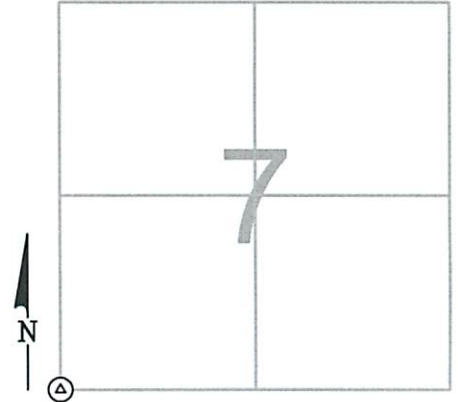

MONUMENT INFORMATION

MONUMENT TYPE: FD. BRASS DISK IN CONCRETE
ON SURFACE - BELOW: 1.5'
LEFT - CL PAV'T - RIGHT: 78.6'

SET ORANGE DELINEATOR 1.5' NORTH OF
MONUMENT.



MISC. INFORMATION

MONUMENT IS IN NORTH BANK OF DITCH WHERE
DITCH TURNS FROM EAST TO NORTH.

THIS IS A CLOSING CORNER.

NOTE:
ALL TIES ARE PLUMB AS
THEY WERE SHOT W/ GPS.

