

# OTTAWA COUNTY ENGINEERS OFFICE

REFERENCE NO. 7-6-16-I  
SOUTHEAST CORNER SEC. 7  
BAY TWP.  
SHEET 1 OF 1.

PERSONNEL:  
M. WITTMAN, P.S.  
J. ALLEN

DATE / WEATHER / TEMP:  
JUNE 19, 2012  
SUNNY - W  
83° F

ROUTE: C-17 OAK HARBOR SOUTHEAST RD.

TOWNSHIP: BAY


SECTION: 7

T 6 NR 16 E.

NORTHING:

EASTING:

DATUM:

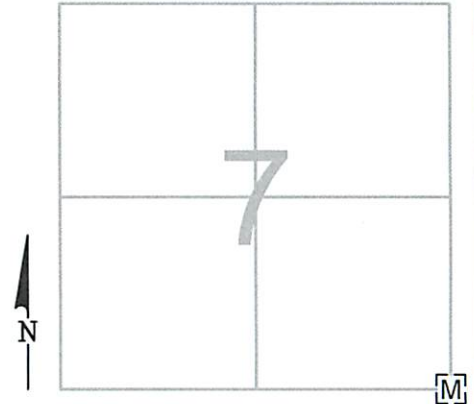

## MONUMENT INFORMATION

MONUMENT TYPE: FD 5/8" Ø IRON PIN IN MON BOX  
ON SURFACE - BELOW: 0.26'  
LEFT - CL PAV'T - RIGHT: 3.30'



## MISC. INFORMATION

OAK HARBOR SOUTHEAST RD., C.R. #17

