

OTTAWA COUNTY ENGINEERS OFFICE

REFERENCE NO. 7-6-16-V
 C/L INT. C-17& T-273 SECTION 7
 BAY TWP.
SHEET 1 OF 1.

ROUTE: C-17 OAK HARBOR SE RD.
 @ T-273 HOPFINGER RD.

TOWNSHIP: BAY

SECTION: 7

T 6 **NR** 16 **E.**

NORTHING:

EASTING:


DATUM:

PERSONNEL:

R. NUHFER, P.S.
 M. BROUGH
 K. MOORE

DATE / WEATHER / TEMP:

JUNE 30, 2000
 SUNNY
 80° F

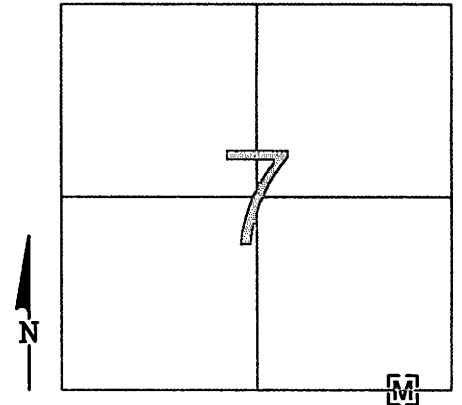

MONUMENT INFORMATION

MONUMENT TYPE: FD IRON PIN IN MON BOX
 ON SURFACE - BELOW:
LEFT - CL PAV'T - RIGHT: 5.65'

MISC. INFORMATION

IRON PIN IN MONUMENT BOX SET PER COUNTY
 ROAD #17 RECONSTRUCTION PLANS

STA. 274+54.42 - 1975 C.R. #17 PLANS

PHOTO NOT AVAILABLE

